SNS (Wes Tabler x6710)

CBP (Olivia & Kymba x5792)

CBP/I'OASIS (Wim Leemans x7788)

CBP/Lambertson Lab (Dave Lozano x6243)

IBT (Ken Barat x7648)

E H & S (Edson Wong x7068)

Building Facilities (Wes Tabler x6710)

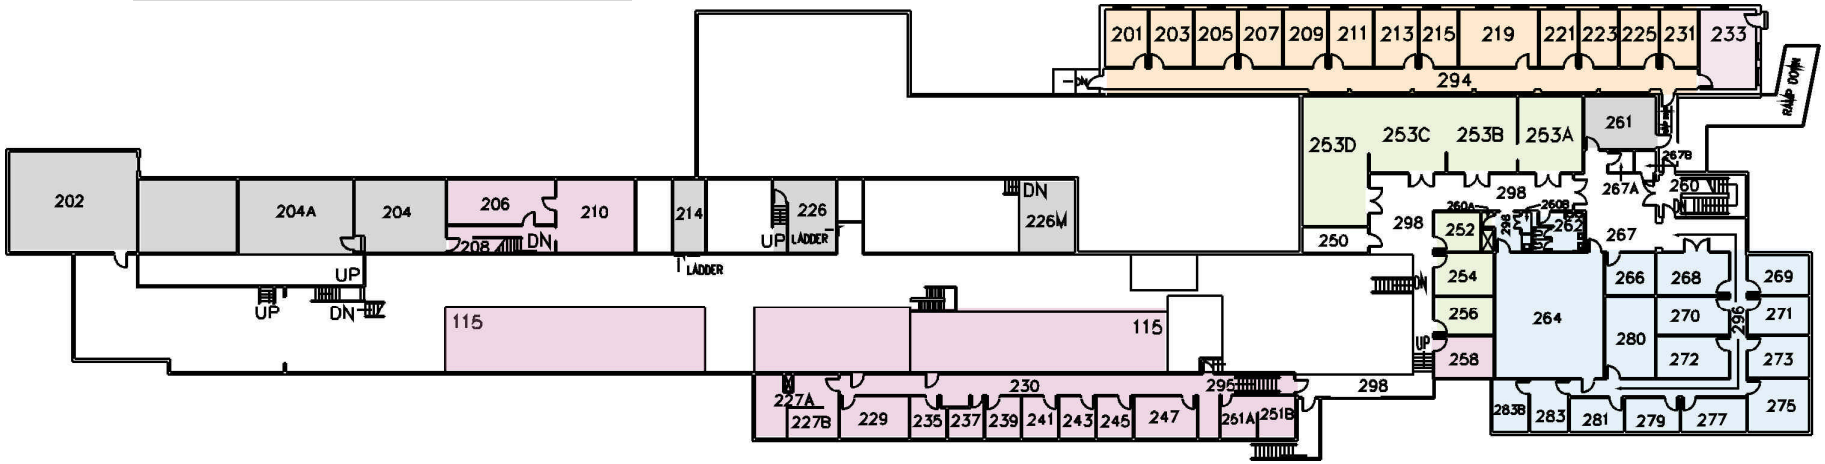

UNIVERSITY OF CALIFORNIA LAWRENCE BERKELEY LABORATORY

ASBUILT CONDITION

date: 020ct01 ksa

71-2

3 of 3