CBP/Theory (Miguel Furman x6443)

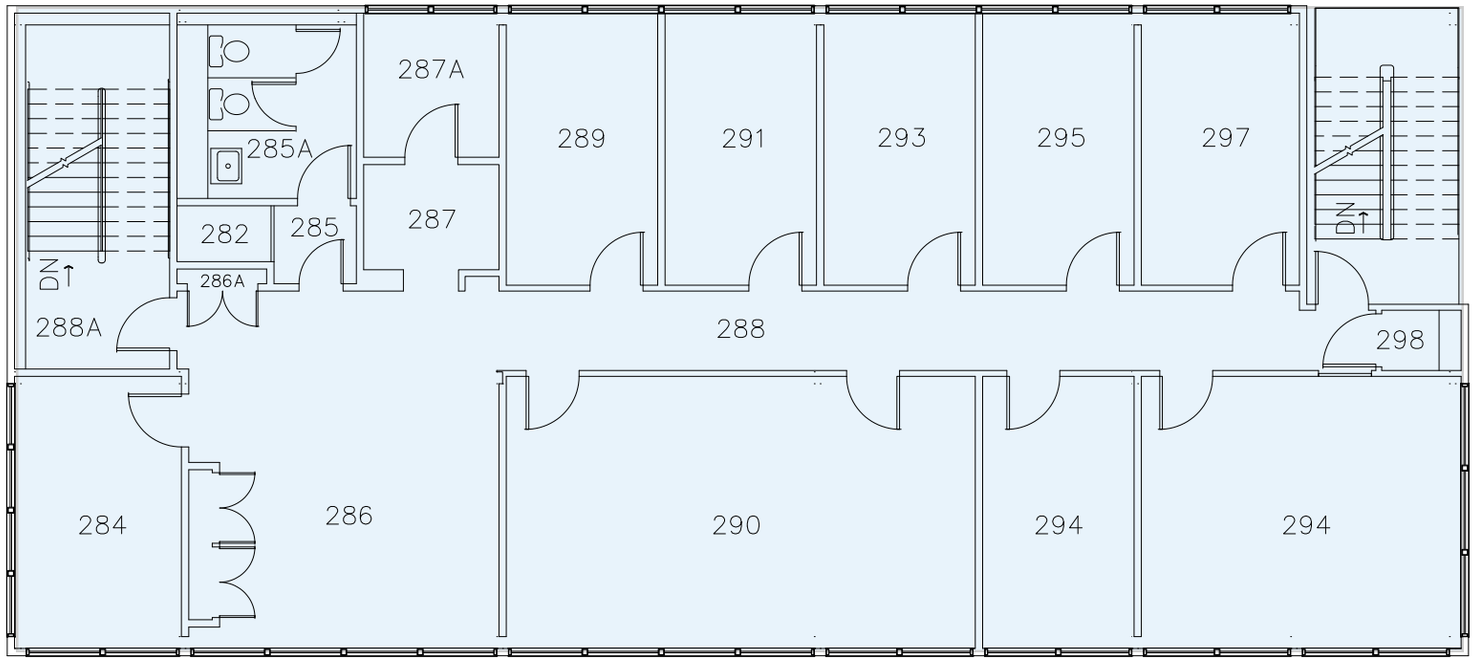

UNIVERSITY OF CALIFORNIA LAWRENCE BERKELEY LABORATORY
FACILITIES DEPARTMENT

0 5 10

ASBUILT CONDITION
KEYPLAN

date: 02Oct01 ksa
check: WC

71B-2 3 of 3